

ADDENDUM 1
CHINA BRIDGE
PART 6

SHEET KEYNOTES

- ① SEE ARCHITECTURAL ELEVATIONS FOR MOUNTING HEIGHTS.
- ② CIRCUIT THROUGH LIGHTING CONTACTOR. SEE LIGHTING CONTROL DETAIL.
- ③ PROVIDE 120V SMOKE DETECTOR AND CONDUIT TO ELEVATOR CONTROL PANEL.
- ④ STUB 1-1/4" CONDUIT FROM THE FUTURE ISLAND TO PANEL B FOR A FUTURE TICKET BOOTH. PROVIDE RIDGID CONDUIT CAP AND MAKE FLUSH WITH DRIVING SURFACES. PROVIDE PULL CORD.
- ⑤ VERIFY HEAT TAPE J-BOX LOCATION WITH THE ARCHITECT.


RECORD DRAWING
DATE: 09/14/2008
THESE RECORD DRAWINGS HAVE BEEN PREPARED BASED ON INFORMATION PROVIDED BY OTHERS. THE DESIGN PROFESSIONAL HAS NOT VERIFIED THE ACCURACY AND/OR COMPLETENESS OF THIS INFORMATION AND SHALL NOT BE RESPONSIBLE FOR ANY ERRORS OR OMISSIONS WHICH MAY BE INCORPORATED HEREIN AS A RESULT.

DATE	STATUS
3.23.2005	CD
8.04.2005	ADDENDUM #1


PROJECT NUMBER	4100
CAD DWG FILE	04298A
DRAWN BY	BNA
CHECKED BY	EF

SCALE

ELECTRICAL PLAN,
PARKING GARAGE
LEVELS 1 & 2
EA1.01

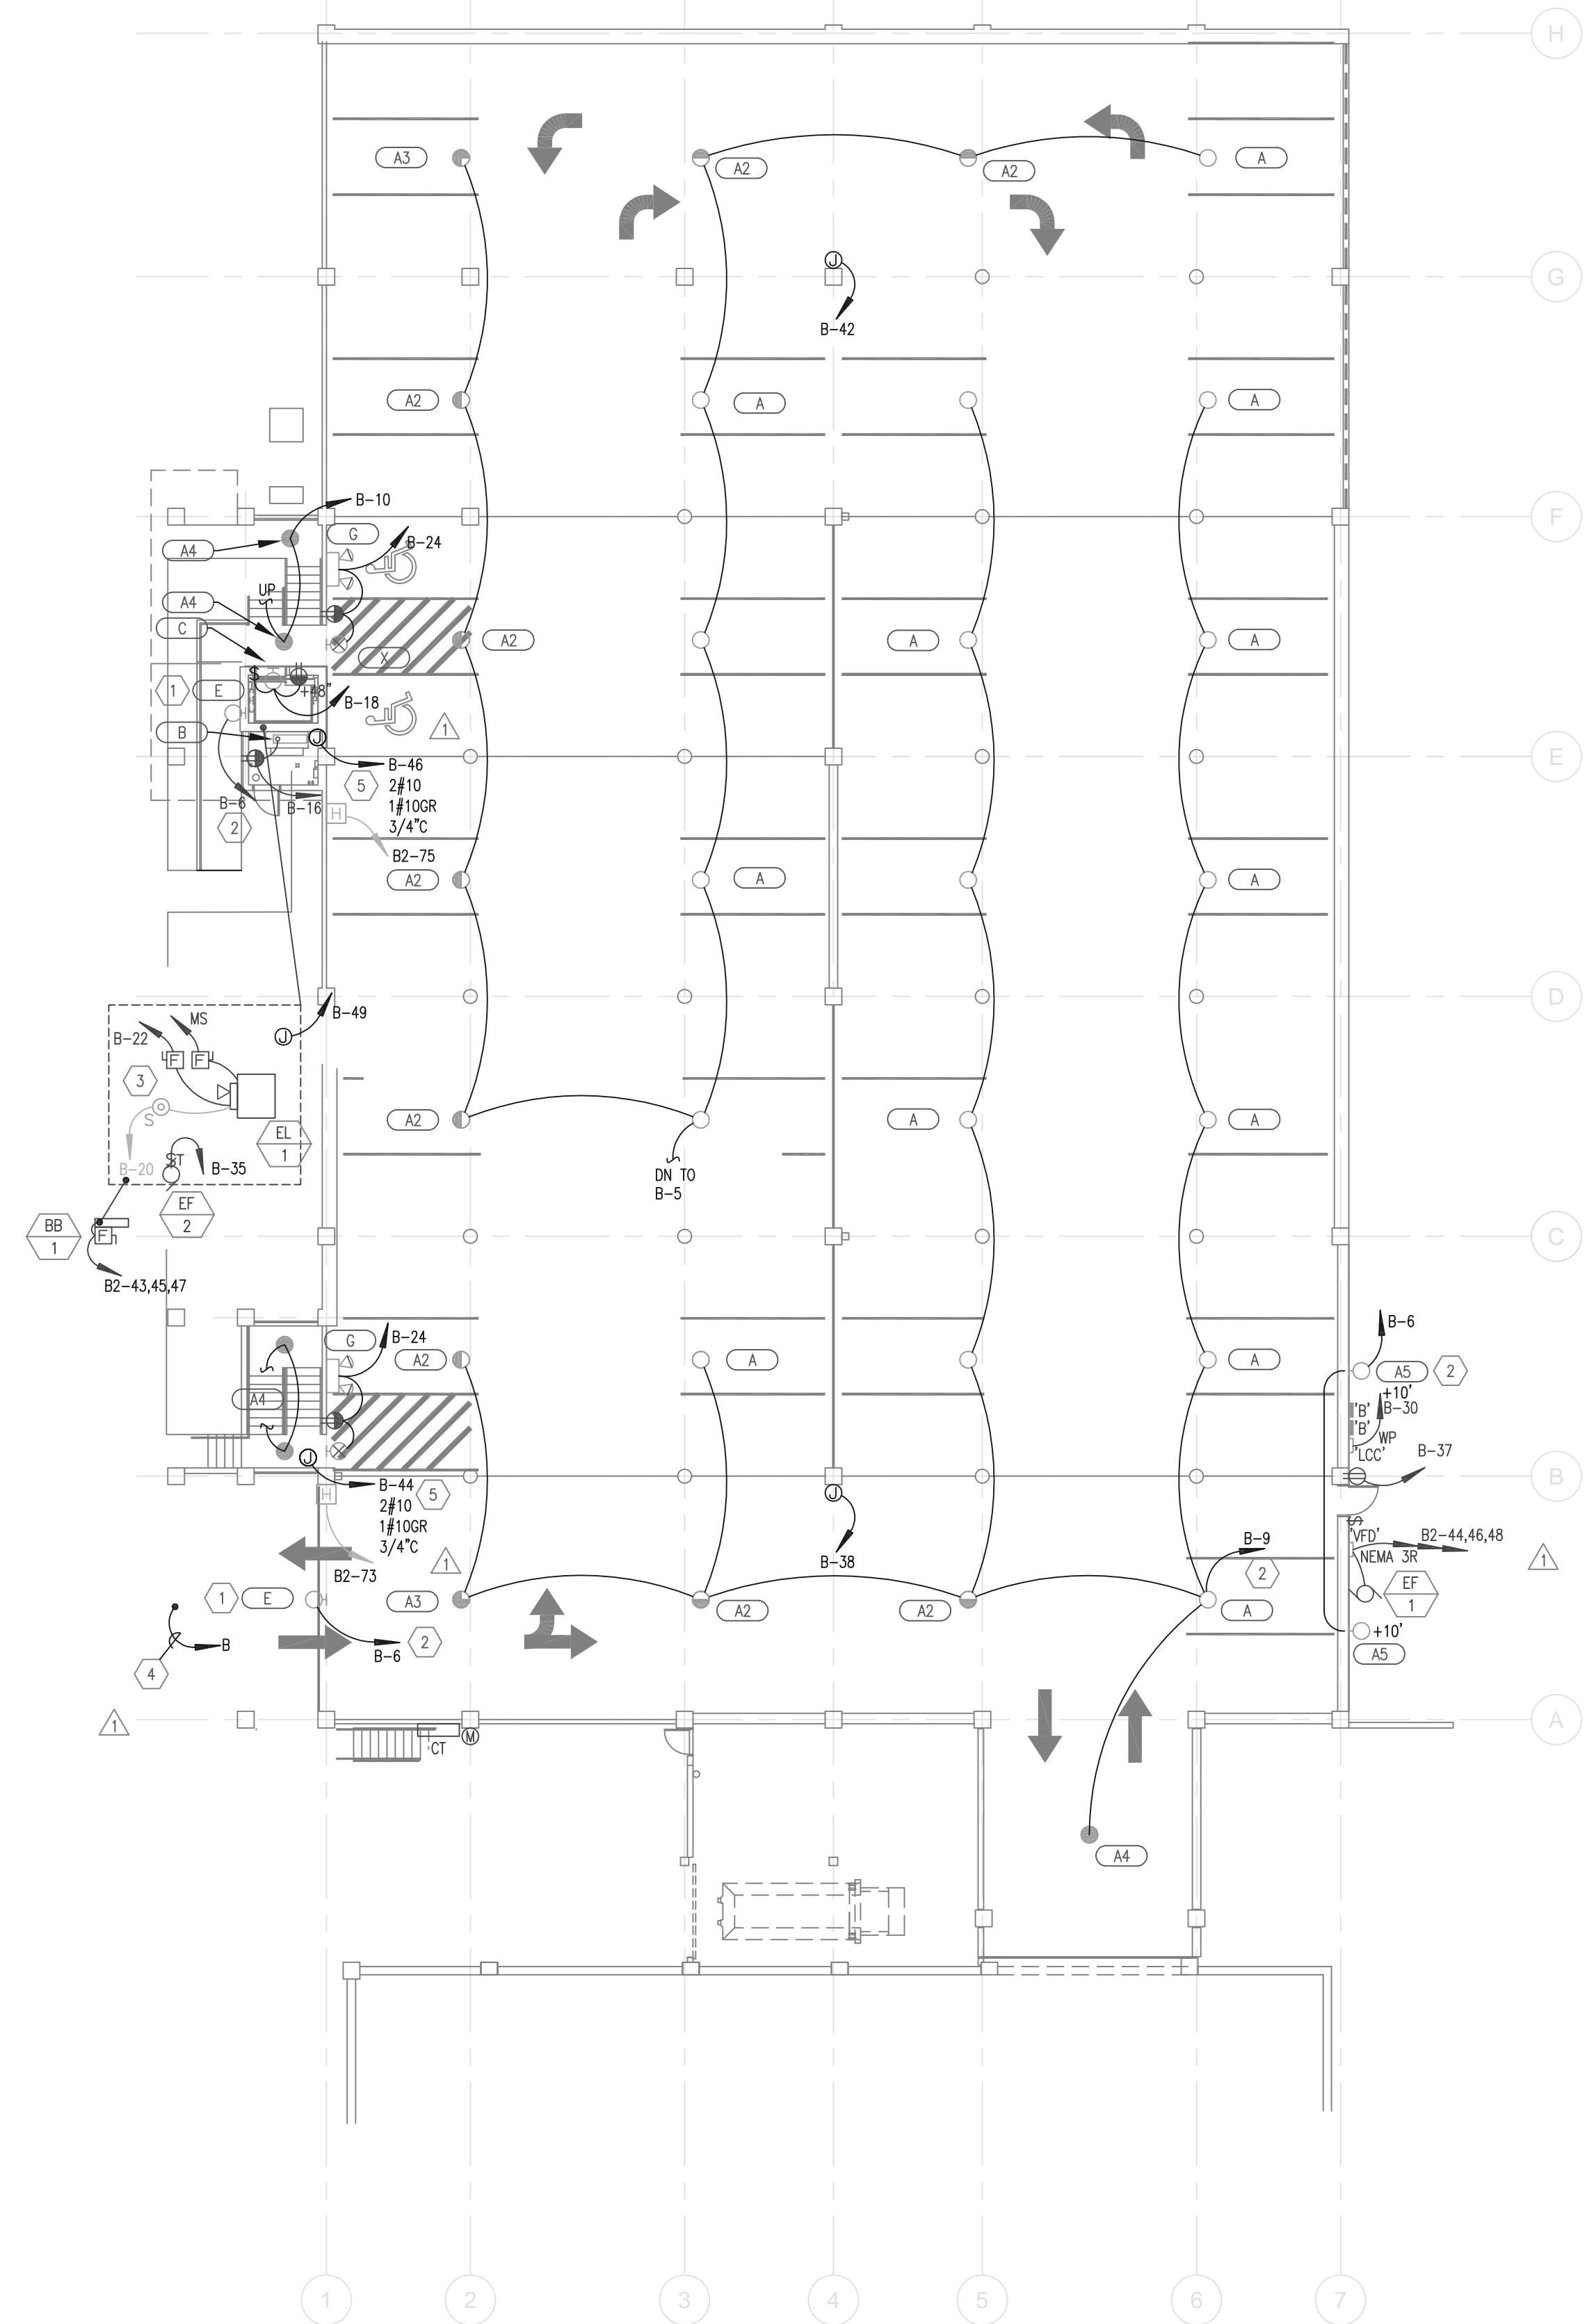

PLAN NORTH
ELECTRICAL PLAN
PARKING GARAGE, LEVEL 2
1/16" = 1'-0"
0 8' 16' 32'

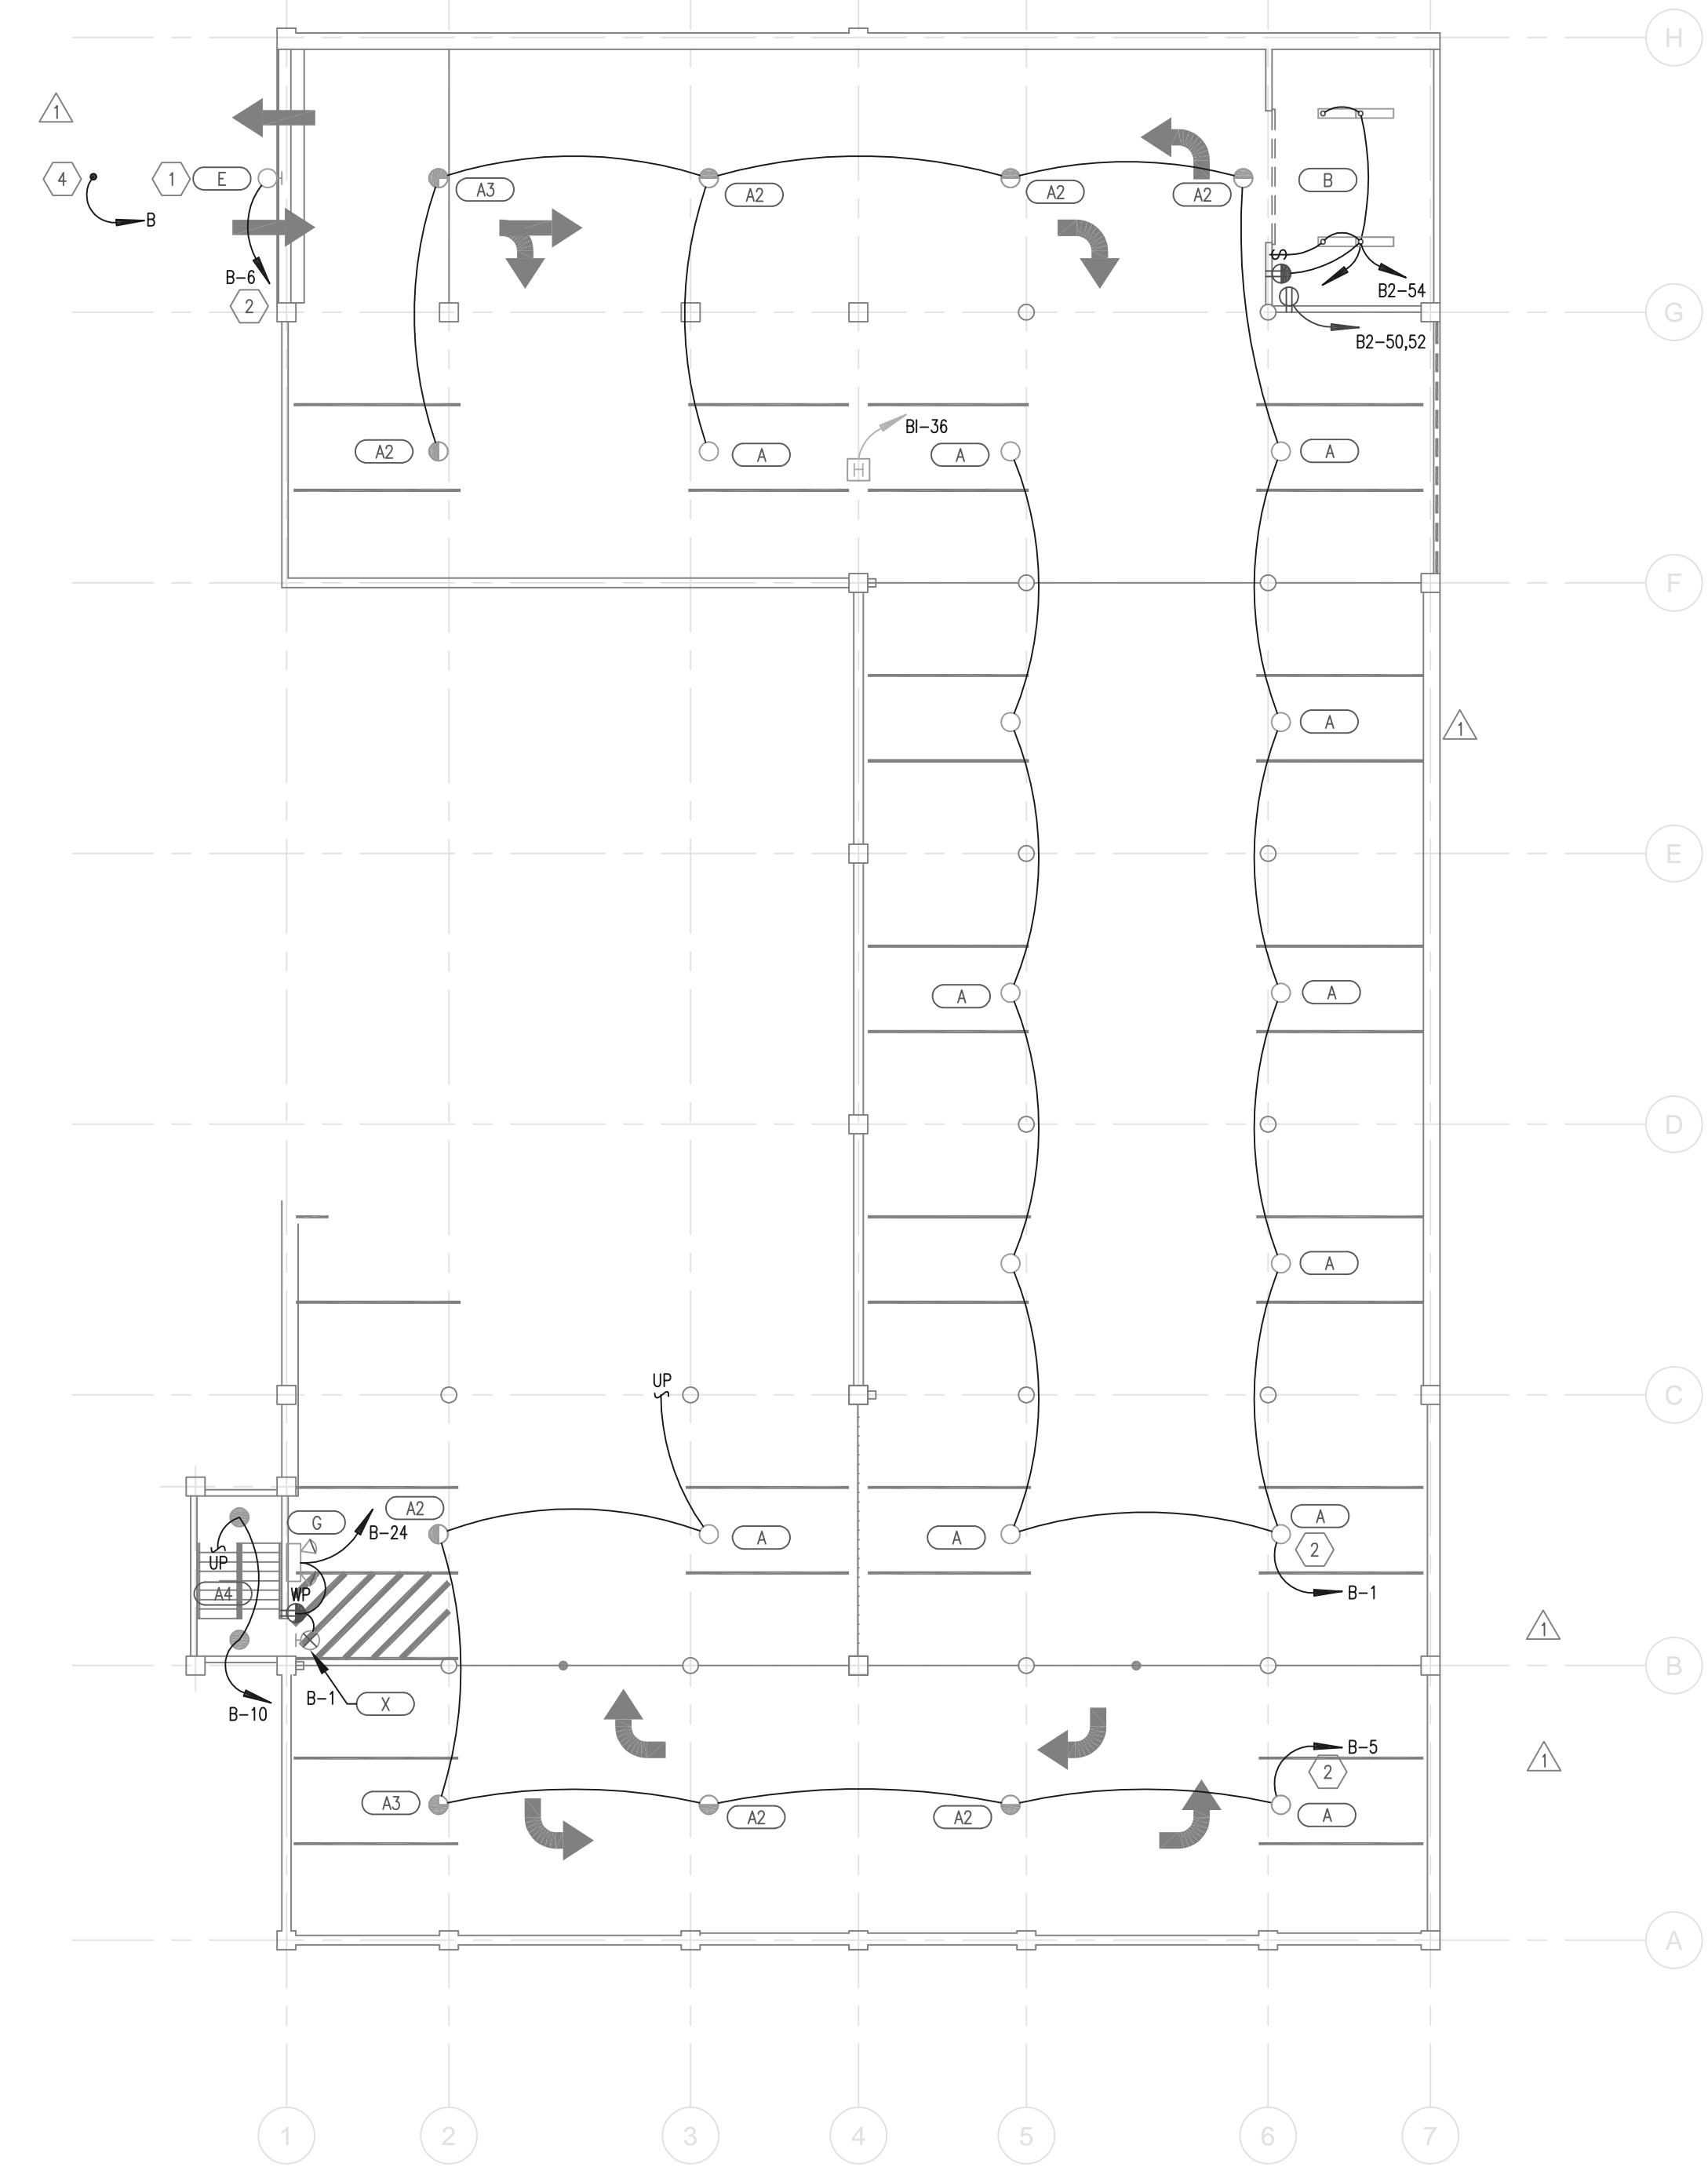

PLAN NORTH
ELECTRICAL PLAN
PARKING GARAGE, LEVEL 1
1/16" = 1'-0"
0 8' 16' 32'

SHEET KEYNOTES

- 1 SEE ARCHITECTURAL ELEVATIONS FOR MOUNTING HEIGHTS.
- 2 CIRCUIT THROUGH LIGHTING CONTACTOR. SEE LIGHTING CONTROL DETAIL.
- 3 VERIFY HEAT JUNCTION BOX LOCATION WITH THE ARCHITECT.

RECORD DRAWING
DATE: 09/14/2008
THESE RECORD DRAWINGS HAVE BEEN PREPARED BASED ON INFORMATION PROVIDED BY OTHERS. THE DESIGN PROFESSIONAL HAS NOT VERIFIED THE ACCURACY AND/OR COMPLETENESS OF THIS INFORMATION AND SHALL NOT BE RESPONSIBLE FOR ANY ERRORS OR OMISSIONS WHICH MAY BE INCORPORATED HEREIN AS A RESULT.


DATE	STATUS
3.23.2005	CD
8.04.2005	ADDENDUM #1

PROJECT NUMBER	4100
CAD DWG FILE	04298A
DRAWN BY	BNA
CHECKED BY	EF


SCALE

ELECTRICAL PLAN,
PARKING GARAGE
LEVELS 3 & 4

EA1.02

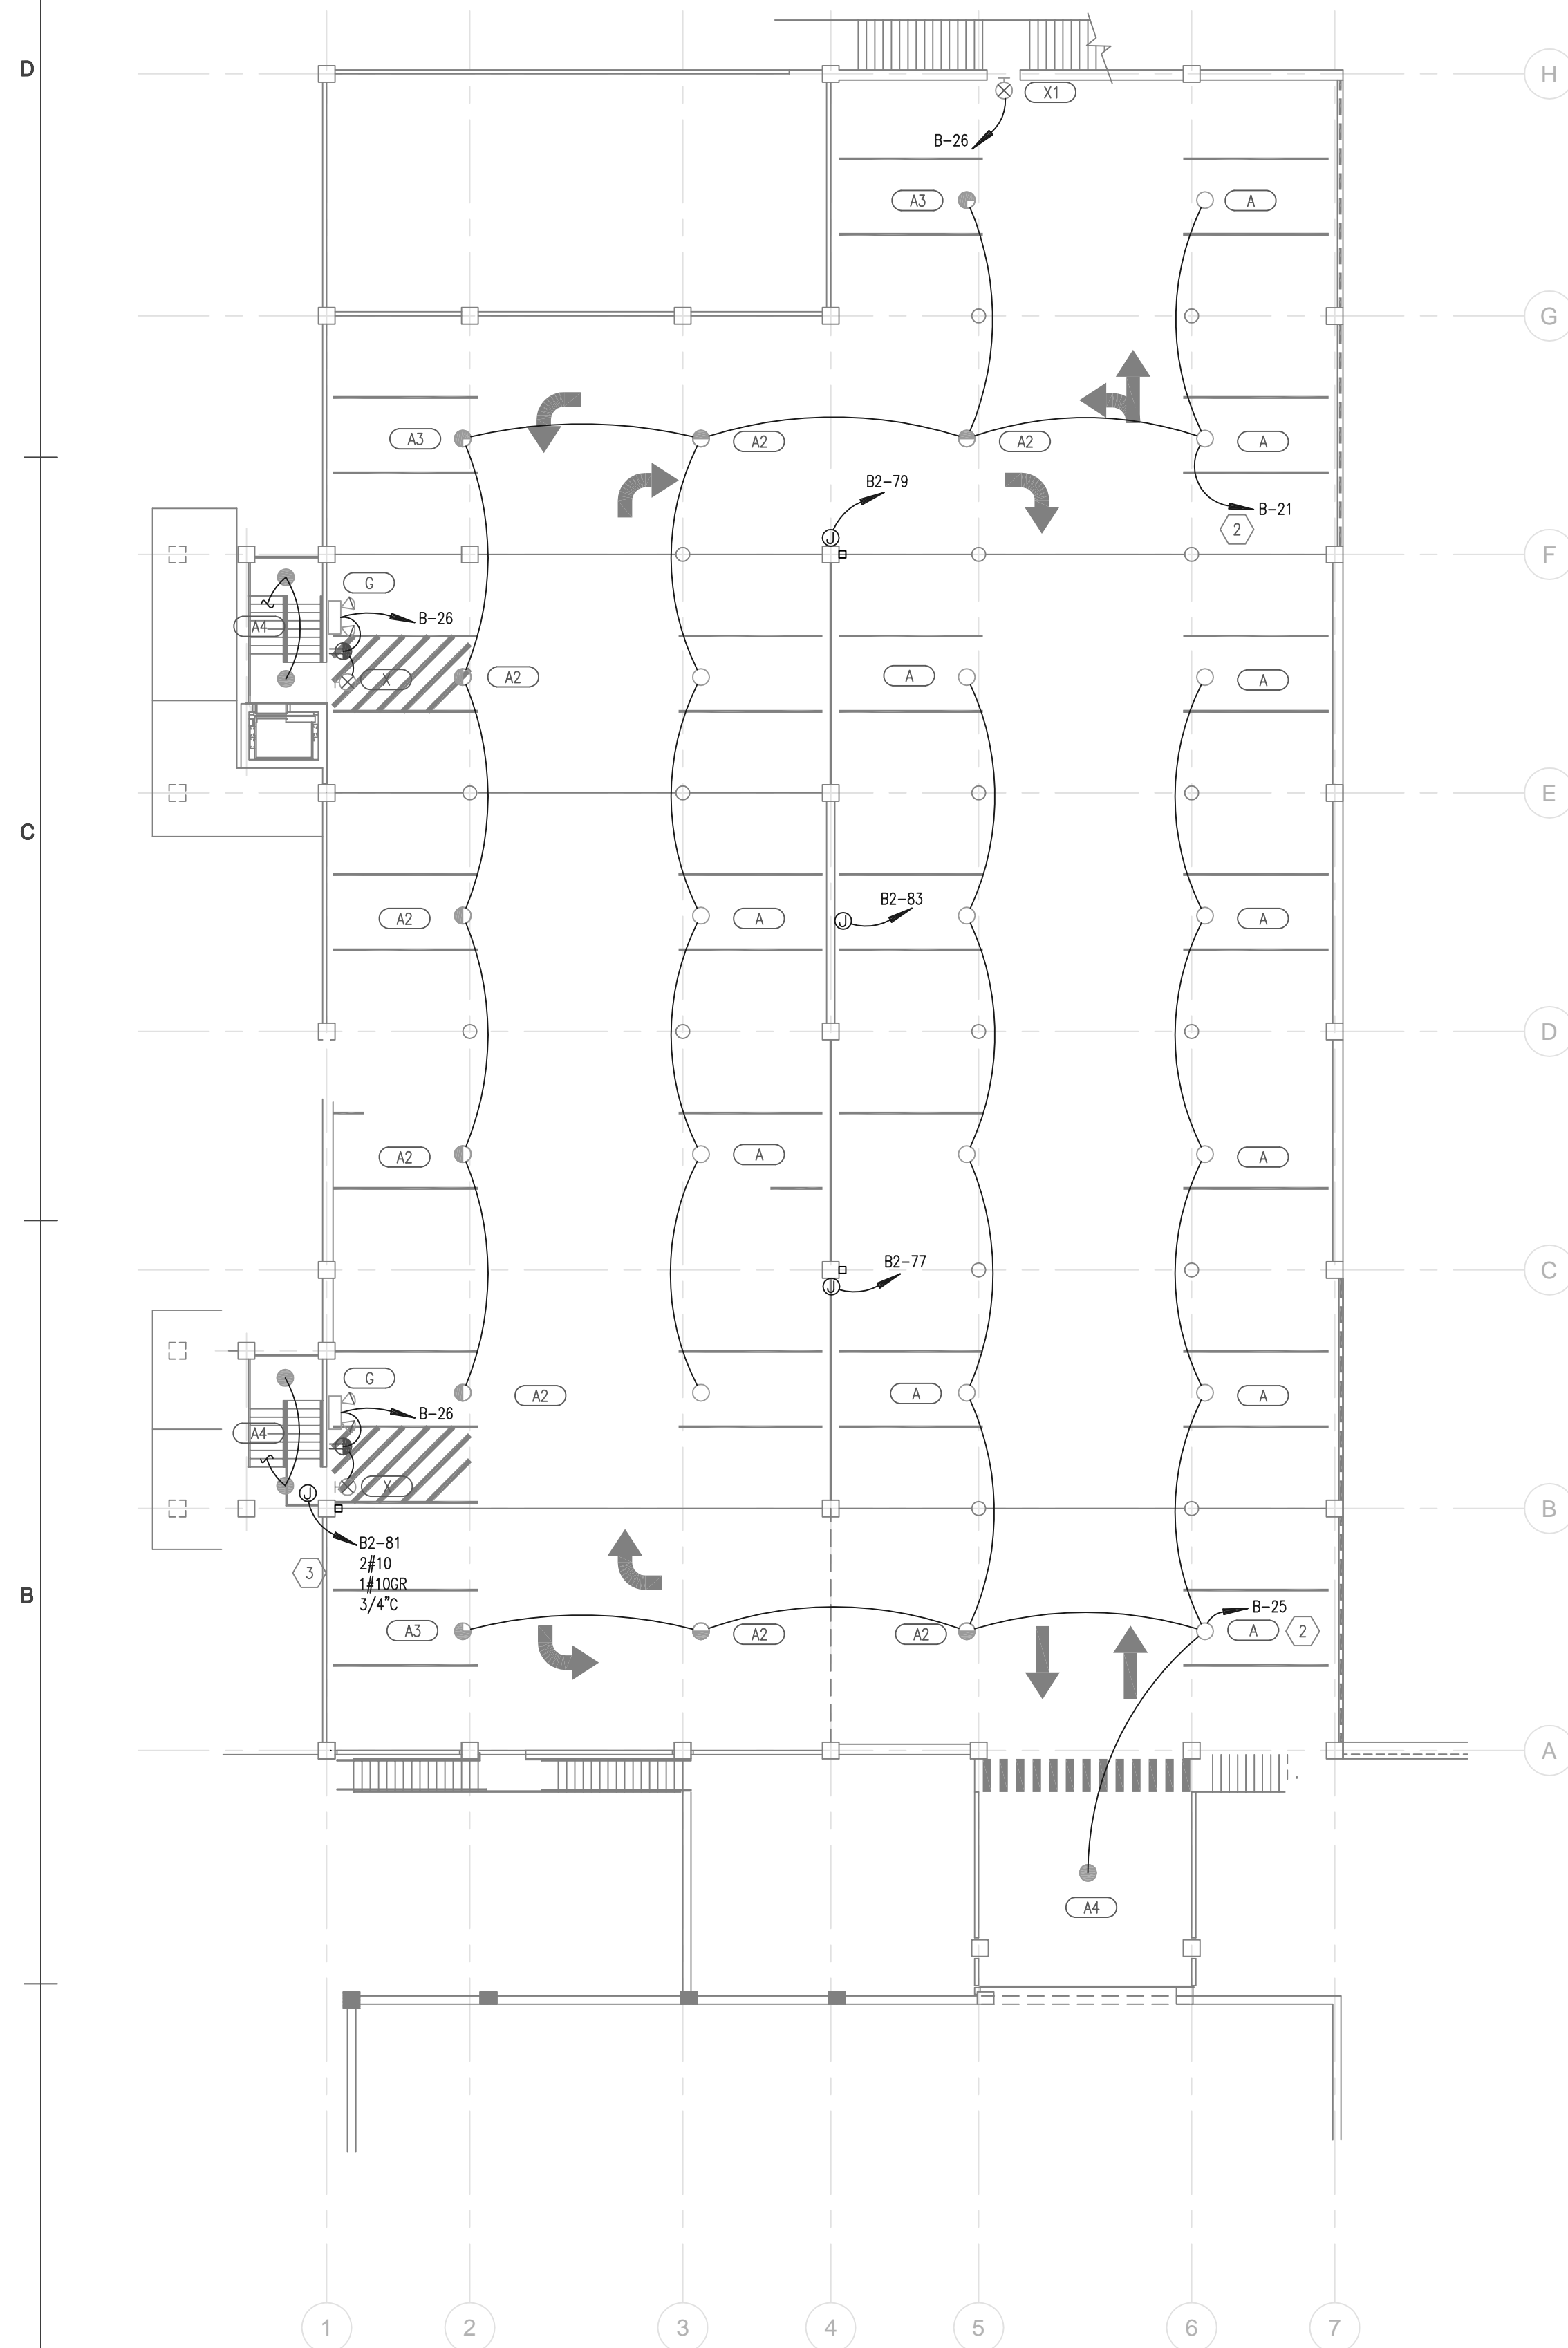


PLAN NORTH
ELECTRICAL PLAN
PARKING GARAGE, LEVEL 4
1/16" = 1'-0"
0 8' 16' 32'

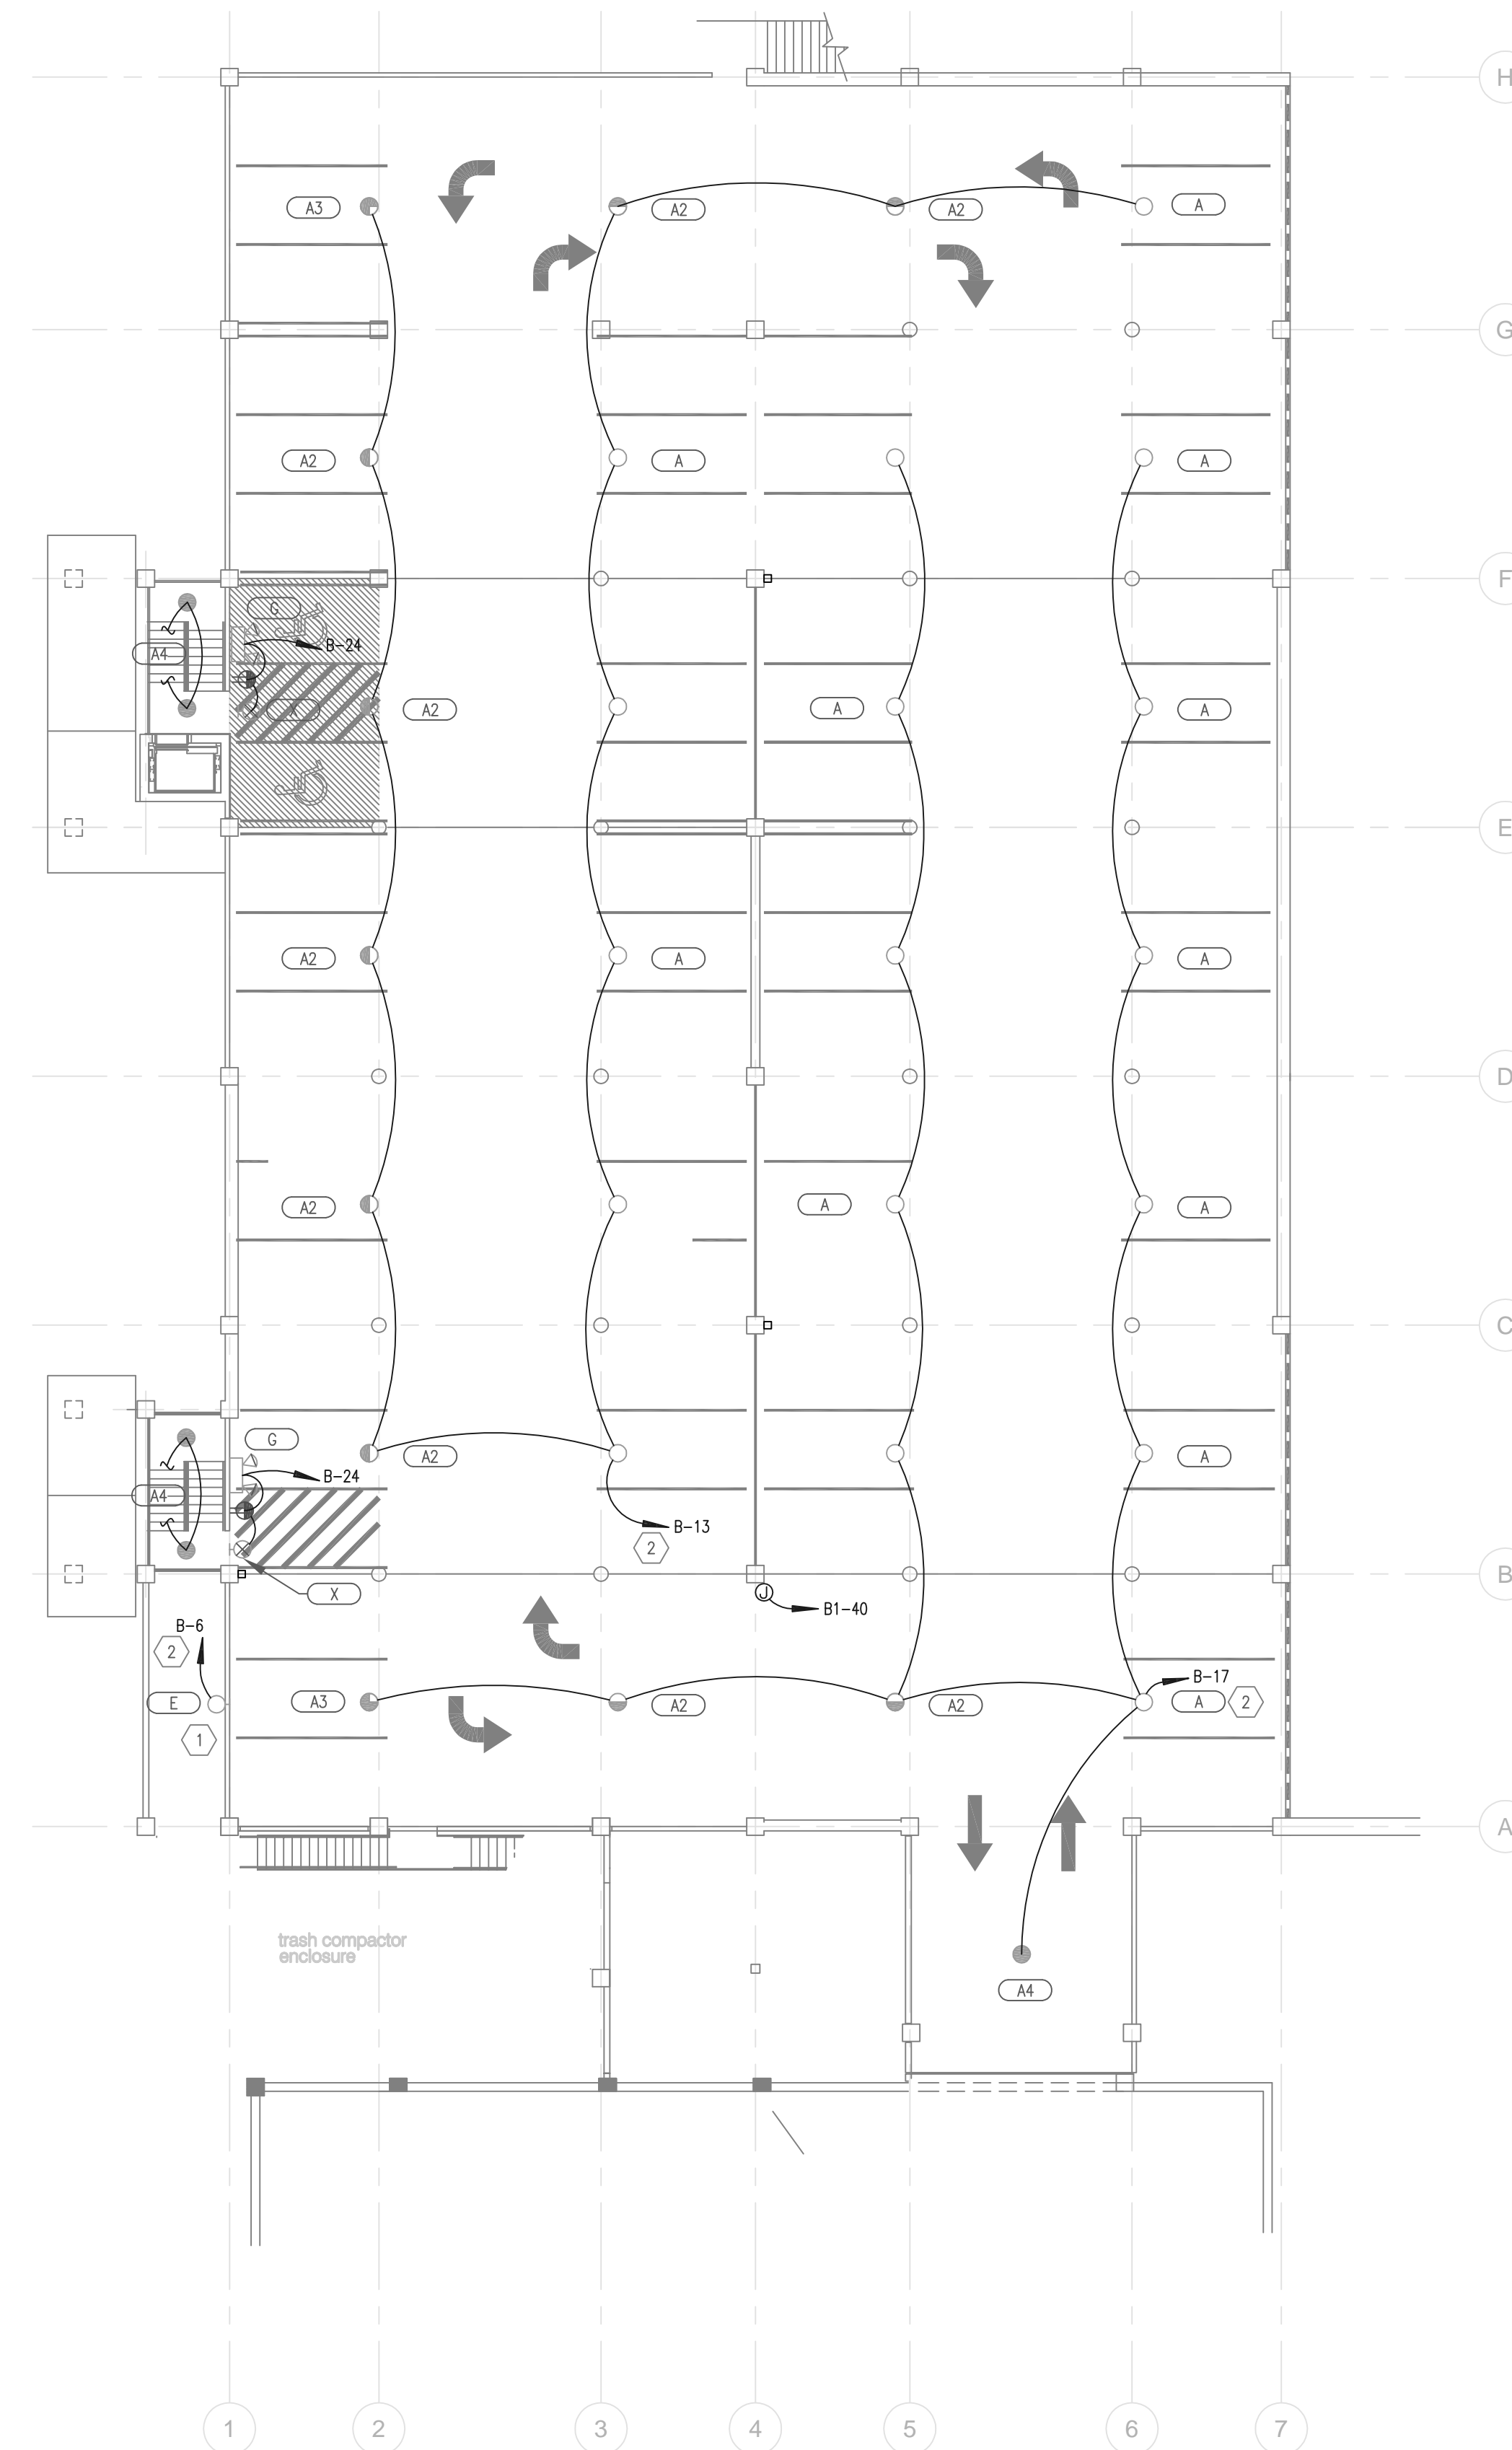

PLAN NORTH
ELECTRICAL PLAN
PARKING GARAGE, LEVEL 3
1/16" = 1'-0"
0 8' 16' 32'

SHEET KEYNOTES

- 1 SEE ARCHITECTURAL ELEVATIONS FOR FIXTURE MOUNTING HEIGHT.
- 2 FLOODLIGHT MOUNTED TO TOP OF COLUMN. AIM AND SHUTTER LIGHT SO ONLY THE CANOPY IS LIT AND THERE IS NO STRAY LIGHT IN THE SKY.
- 3 CIRCUIT THROUGH LIGHTING CONTACTOR. SEE LIGHTING CONTROL DETAIL.
- 4 LIGHTS ARE LOCATED ON LEVEL 4. VERIFY EXACT LOCATION WITH THE ARCHITECT.
- 5 COORDINATE INSTALLATION OF LIGHT FIXTURE POLE ANCHORS ON EXTENDED COLUMNS WITH THE STRUCTURAL ENGINEER AND THE ARCHITECT.

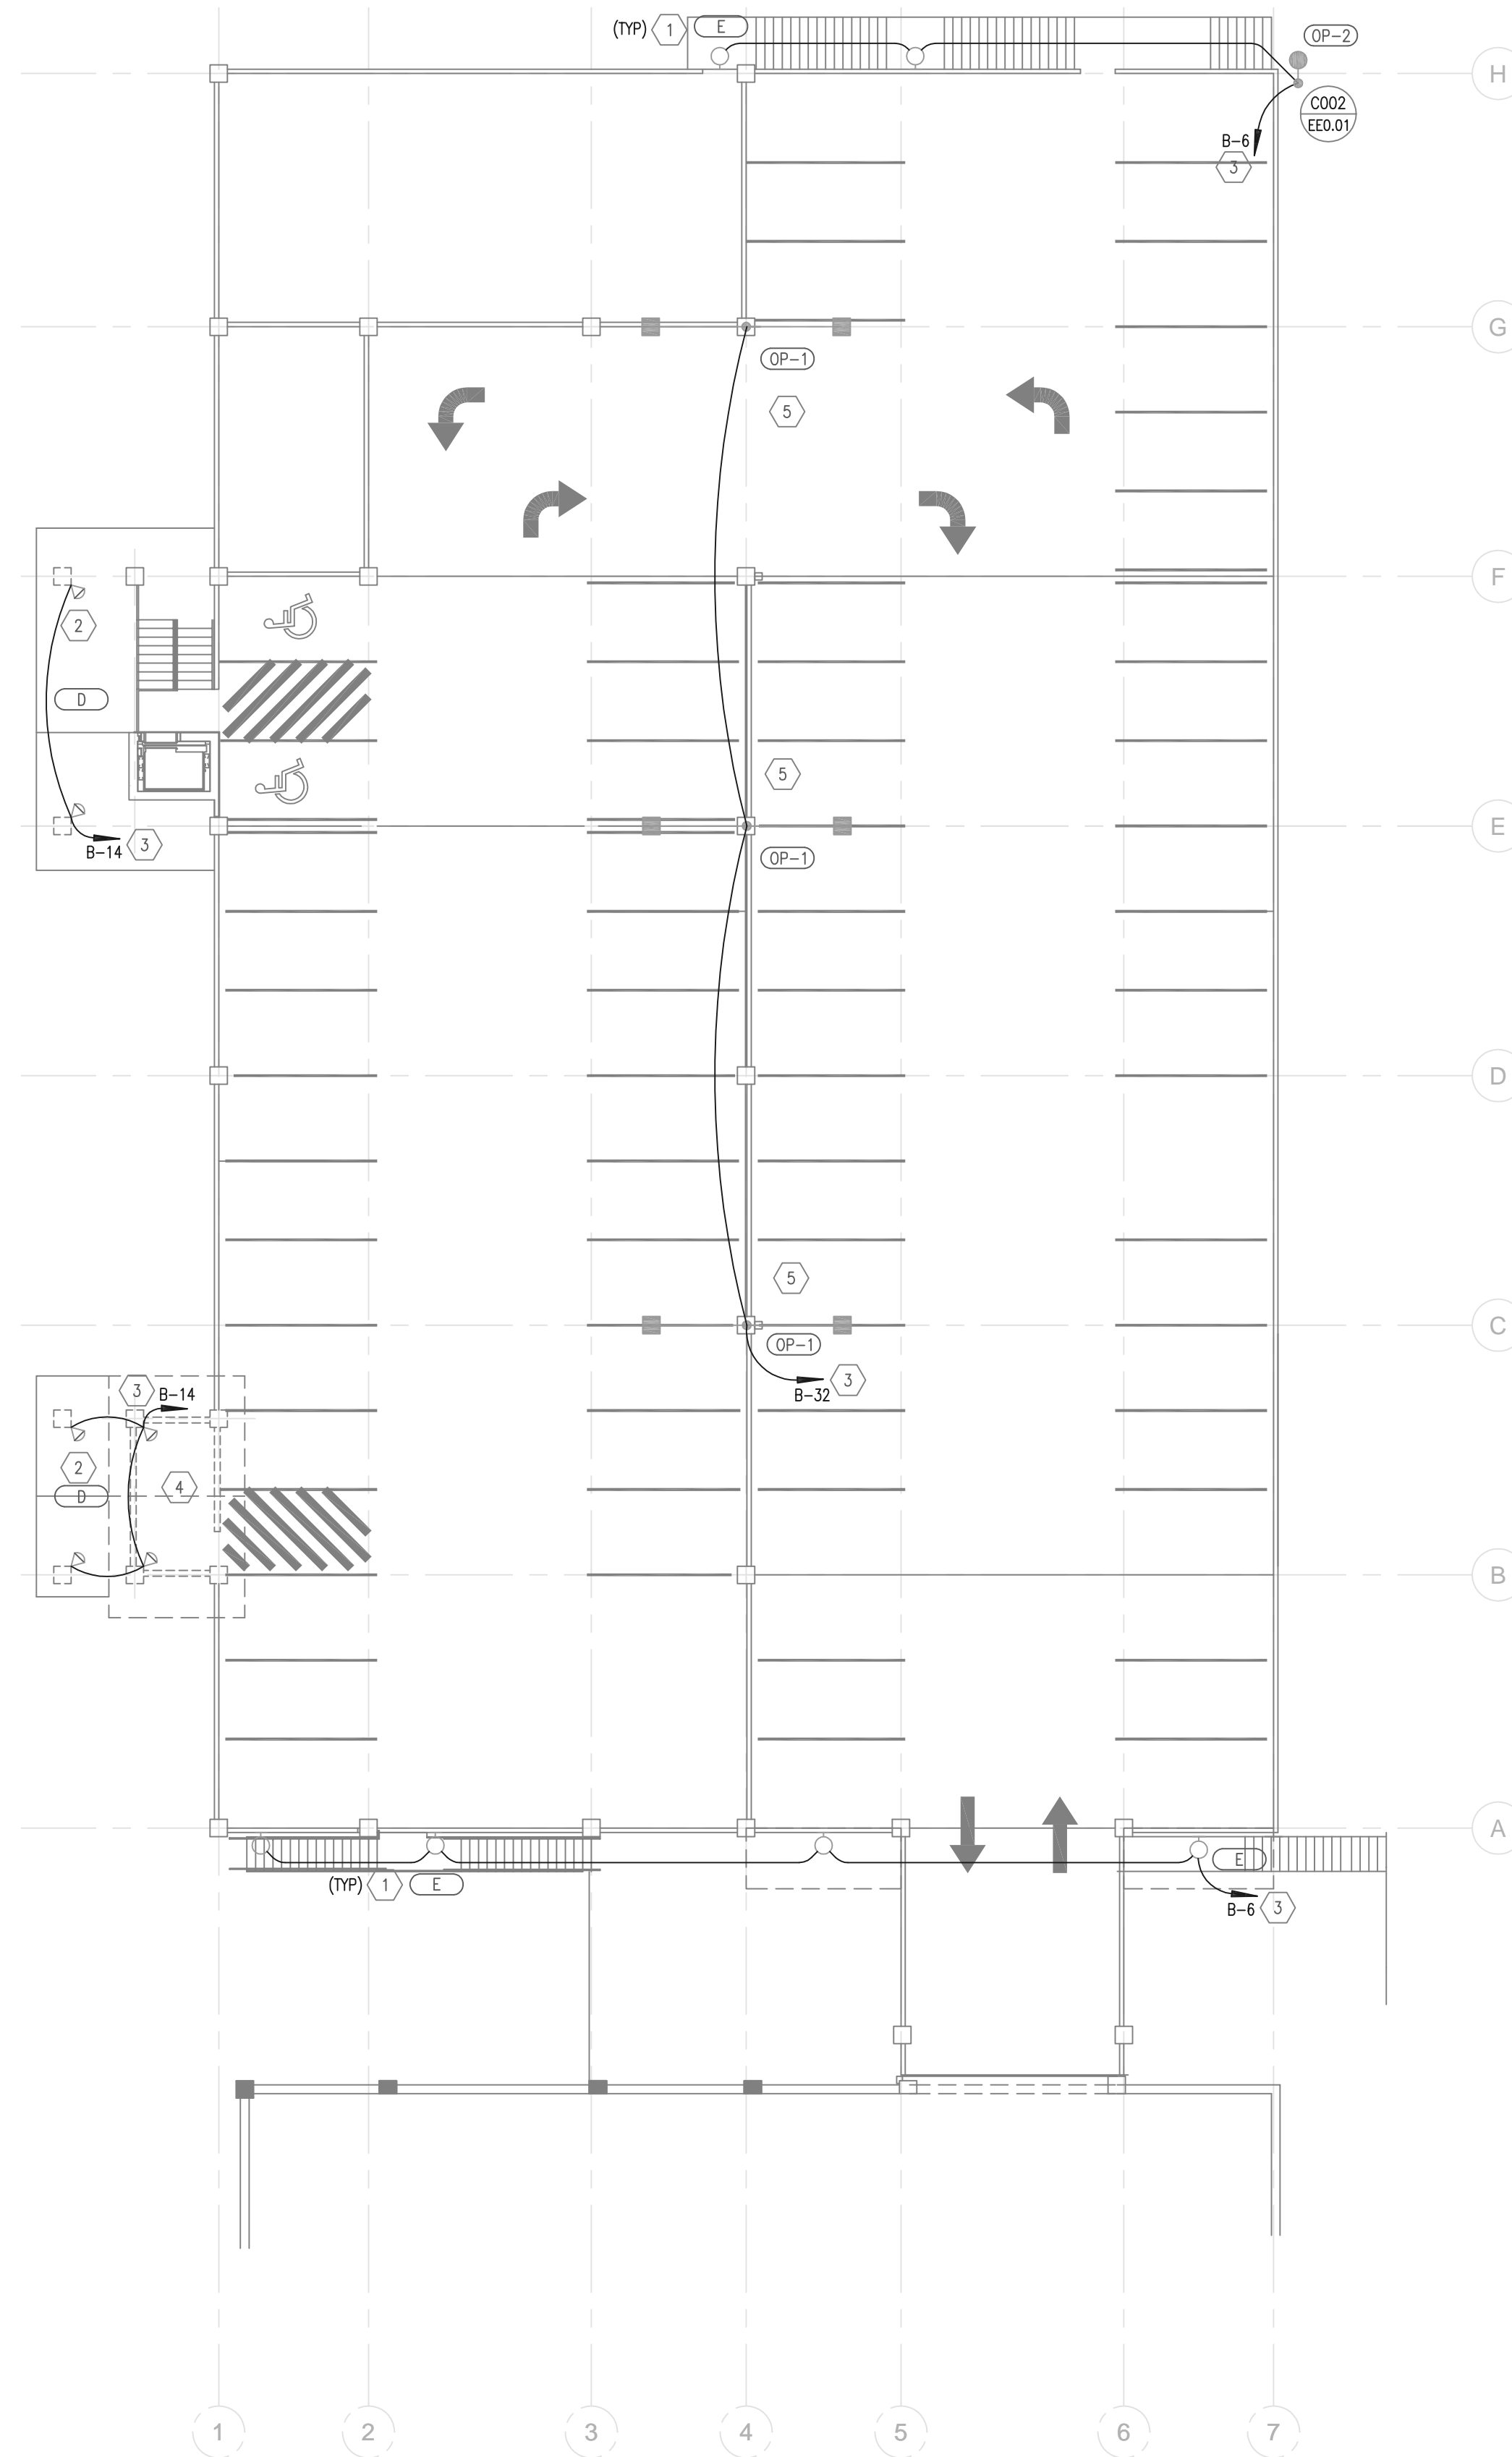

PLAN NORTH
 ELECTRICAL PLAN
 PARKING GARAGE, LEVEL 5
 1/16" = 1'-0"
 0 8' 16' 32'

By: Revit: 15_2005 - 7446rs
 P:\2004\286A\DRAWN\286A-EA103.dwg



Bogue Building
 730 Pacific Avenue
 Salt Lake City
 Utah 84104
 801.521.6186 tel
 801.539.1916 fax
 www.ffkr.com

BNA CONSULTING
 Lighting Design & Electrical Engineering
 SALT LAKE ST. GEORGE LAS VEGAS PHOENIX
 435 South State Street P.O. Box 2196
 Salt Lake City, Utah 84111 P. 801.522.2196
 F. 801.522.2199
 © 2005 BNA CONSULTING www.bnaconsulting.com

China Bridge Parking Expansion
 Park City UT
 Construction Documents

RECORD DRAWING
 DATE: 09/14/2008
 THESE RECORD DRAWINGS HAVE BEEN PREPARED BASED ON INFORMATION PROVIDED BY OTHERS. THE DESIGN PROFESSIONAL HAS NOT VERIFIED THE ACCURACY AND/OR COMPLETENESS OF THIS INFORMATION AND SHALL NOT BE RESPONSIBLE FOR ANY ERRORS OR OMISSIONS WHICH MAY BE INCORPORATED HEREIN AS A RESULT.

DATE	STATUS
3.23.2005	CD
8.04.2005	ADDENDUM #1

PROJECT NUMBER: 4100
 CAD DWG FILE: 04298A
 DRAWN BY: BNA
 CHECKED BY: EF

SCALE:
 ELECTRICAL PLAN,
 PARKING GARAGE
 LEVEL 5
 EA1.03

